

OFFICE OF THE MARION COUNTY SURVEYOR

SECTION RECORD CORNER

SECTION 8 TOWNSHIP 16 RANGE 3

DATE: 9-22-08

PARTY CHIEF: Wilcoxon

CREW: \_\_\_\_\_

TYPE OF MARKER: Harrison monument



METHOD OF ESTABLISHMENT: County: 6-9-04

IN. S.P.C. E ZONE NAD '83

NAME: 16030804

N: 510571.8170(m)

E: 51298.7950(m)

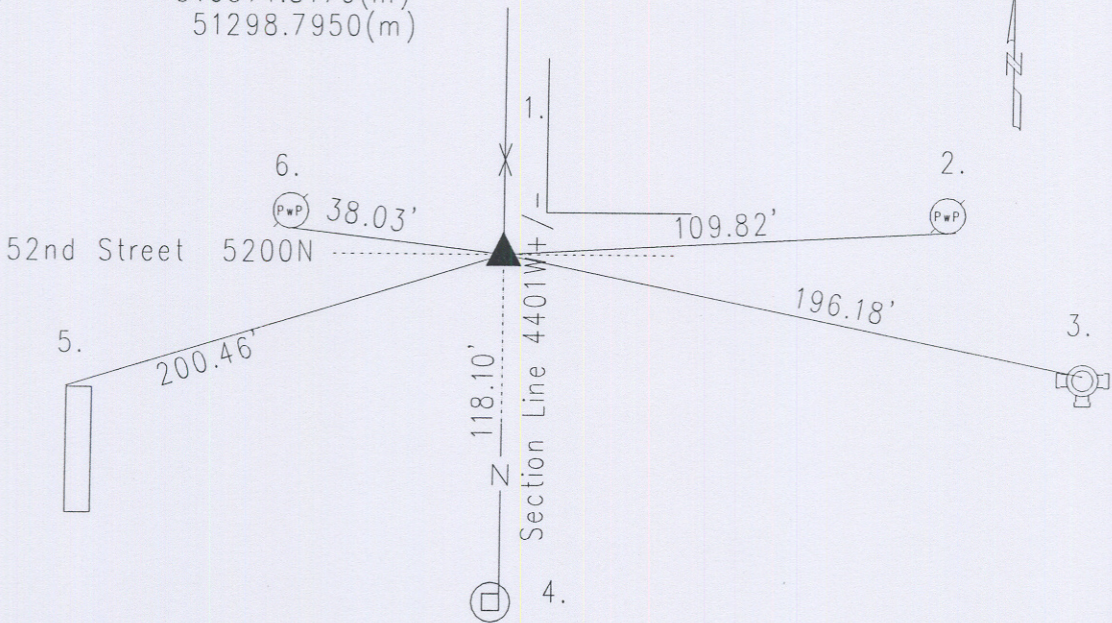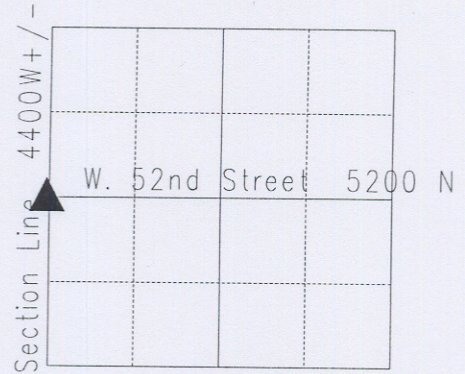

**CORNER HISTORY:** W Q 8-16-3. Reference information as per 1883 Atlas page 7, reflects 6" beech N 67 E 4 links; 8" dogwood S 27 W 5 links. Pike Township Legal Survey Book 6 page 13 by D.B. Hosbrook, 11-25-1851 reflect these witnesses: 20" beech S 61 ½ degrees E 10 links; 6" beech N 61 ½ degrees W 3 links. No reference was found in the 3"x5" old tie cards. Corner reference dated 10-31-75 by R. Miller called Brass plug in steel box. Corner reference dated 4-3-79 by Wilcoxon called rotten post in concrete. Corner reference dated 8-12-86 by R. Miller called brass plug in steel box. Corner reference dated 7-6-1999 by Kiste called brass plug in steel box down 3". Corner reference dated 6-09-2004 by Wilcoxon called set survey mark nail over brass plug in steel box down 3". Corner reference dated 9-22-08 by Wilcoxon called found brass plug in steel box 5" down; old stake w/pipe and set a Harrison monument.

16030804

REF.	DISTANCE	DESCRIPTION
1.	18.43'	Due N to SW corner of concrete block fence 12"up
2.	109.82'	PK nail w/MCS brass washer S PwP#58-328B 4"up
3.	196.18'	Top nut of fire hydrant
4.	118.10'	Due S to cut 'x' E side of concrete light post base
5.	200.46'	NW corner of concrete sign for: Guion Creek Middle School 48" up
6.	38.03'	Mag nail w/MCS brass washer S PwP#16-327B 4"up